




PLAN VIEW  
SCALE 1:250

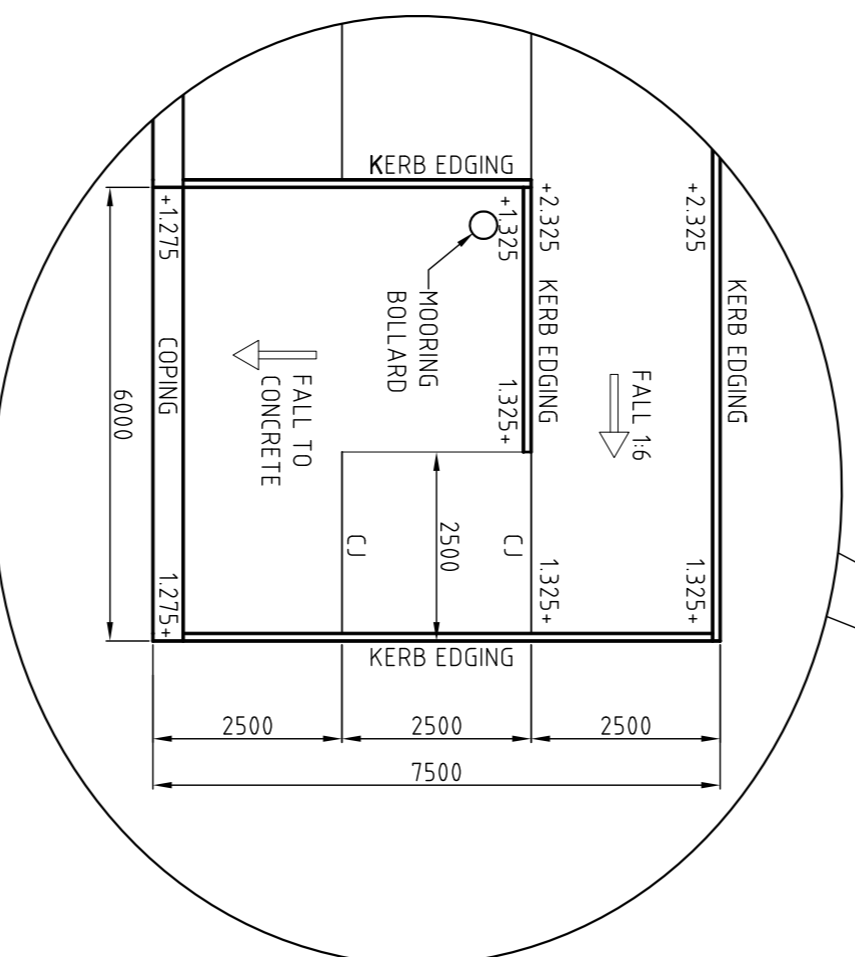


SINGLE BAY PLAN VIEW  
SCALE 1:100

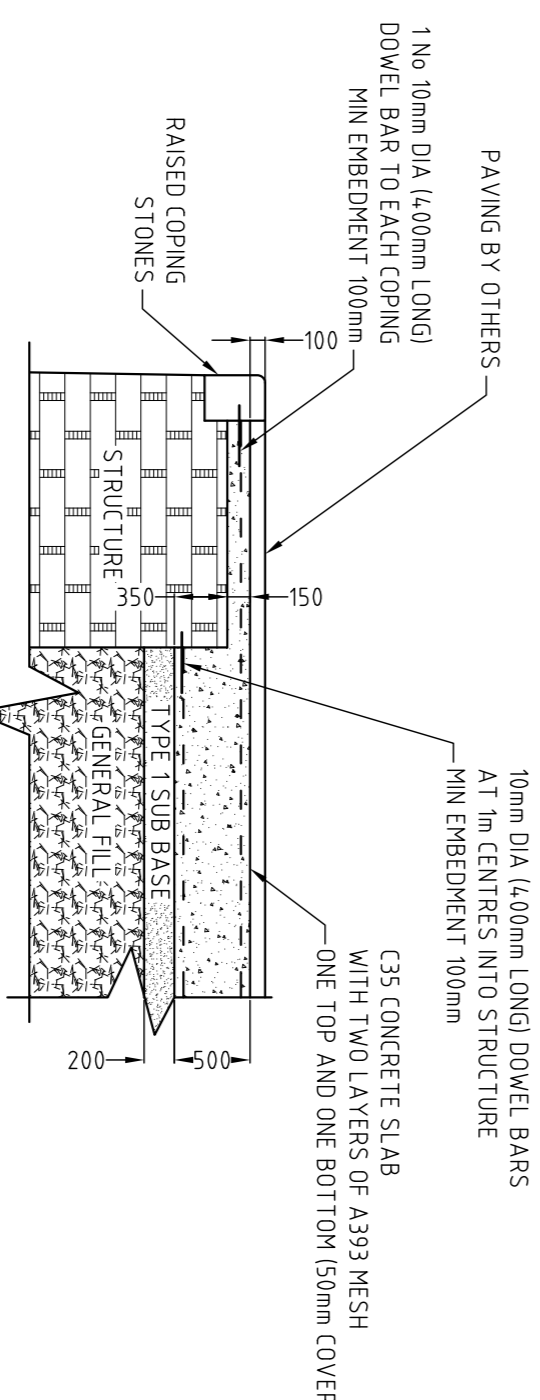


SECTION THROUGH  
PROMONTORY  
SCALE 1:50

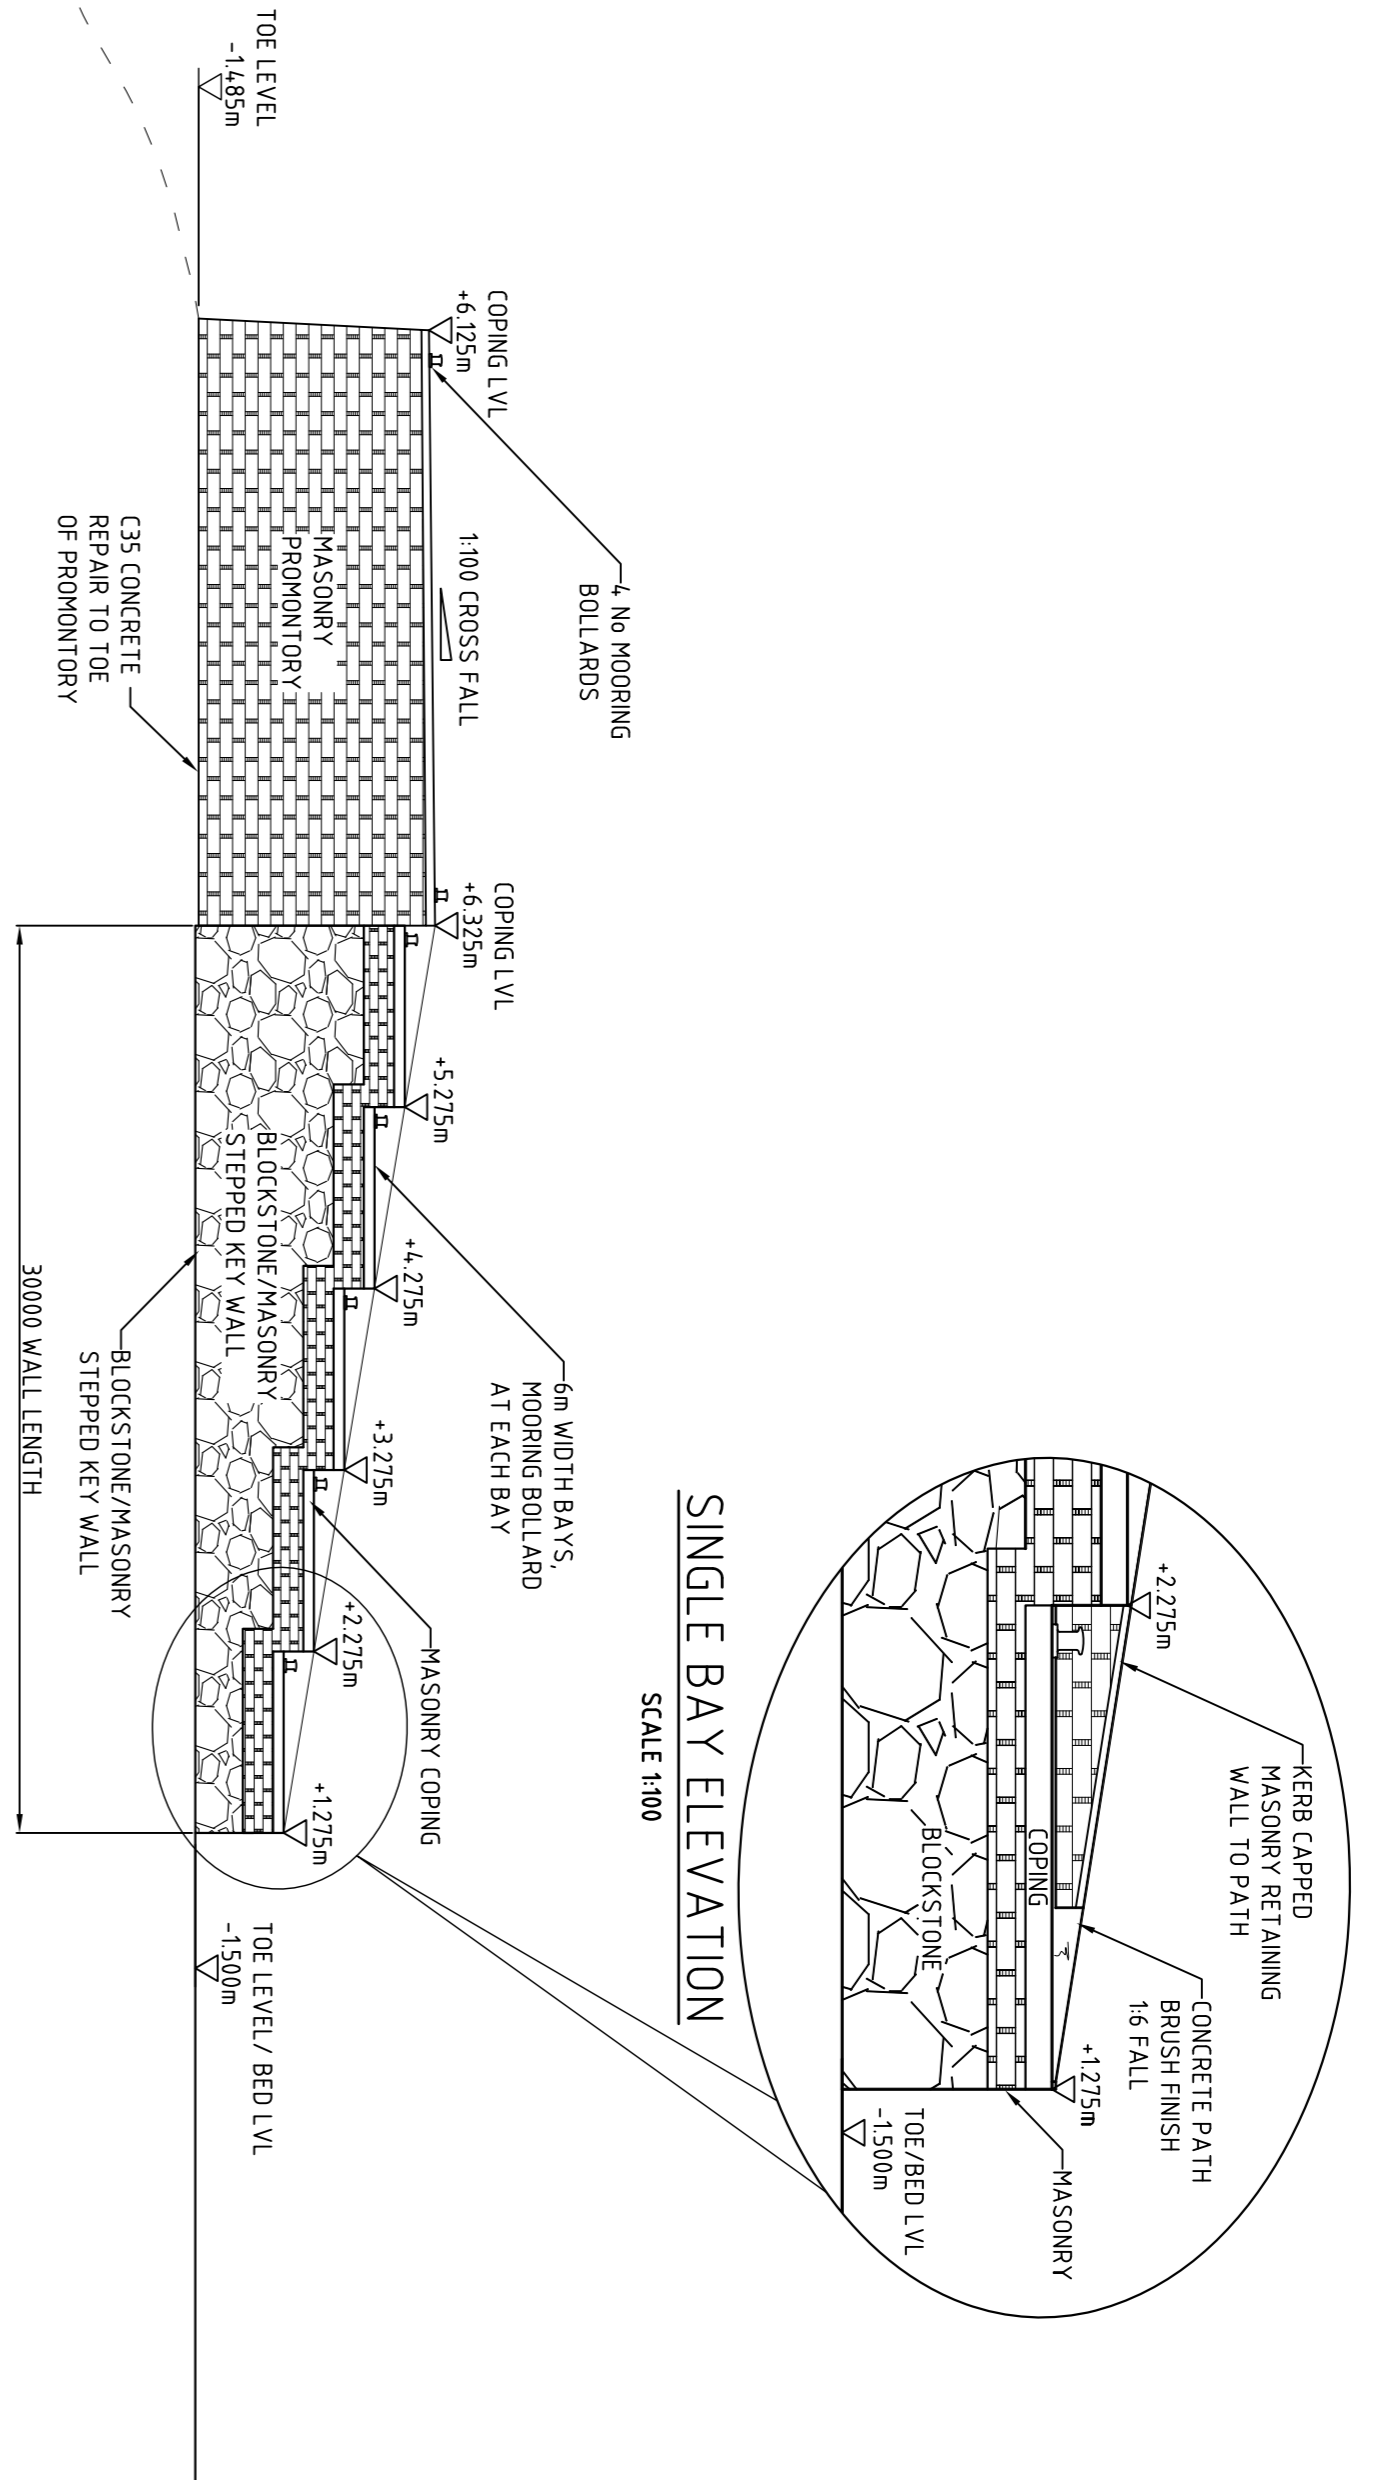

ELEVATION A  
SCALE 1:250

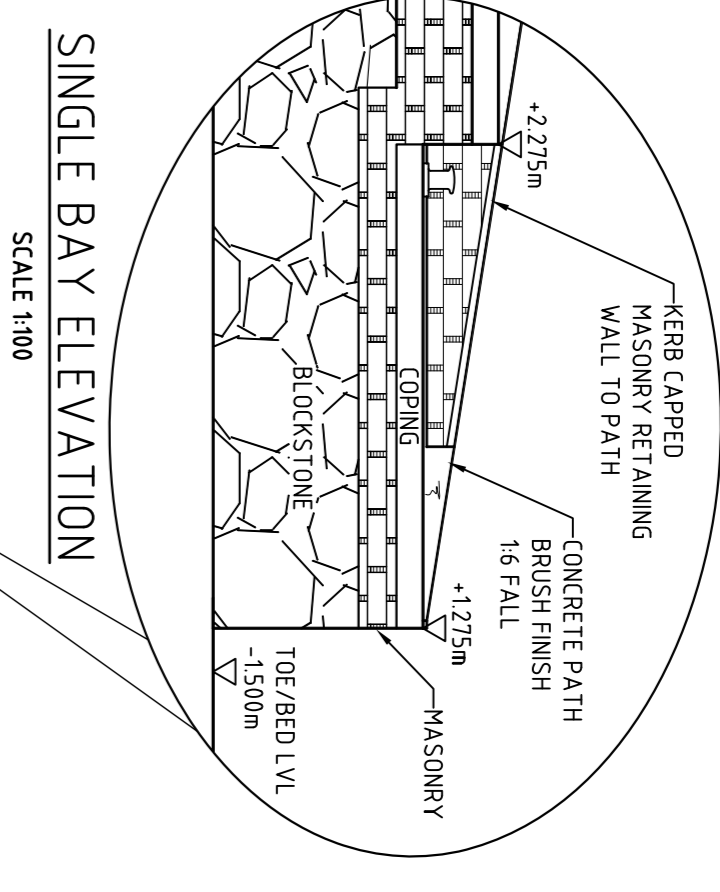

SINGLE BAY ELEVATION  
SCALE 1:100

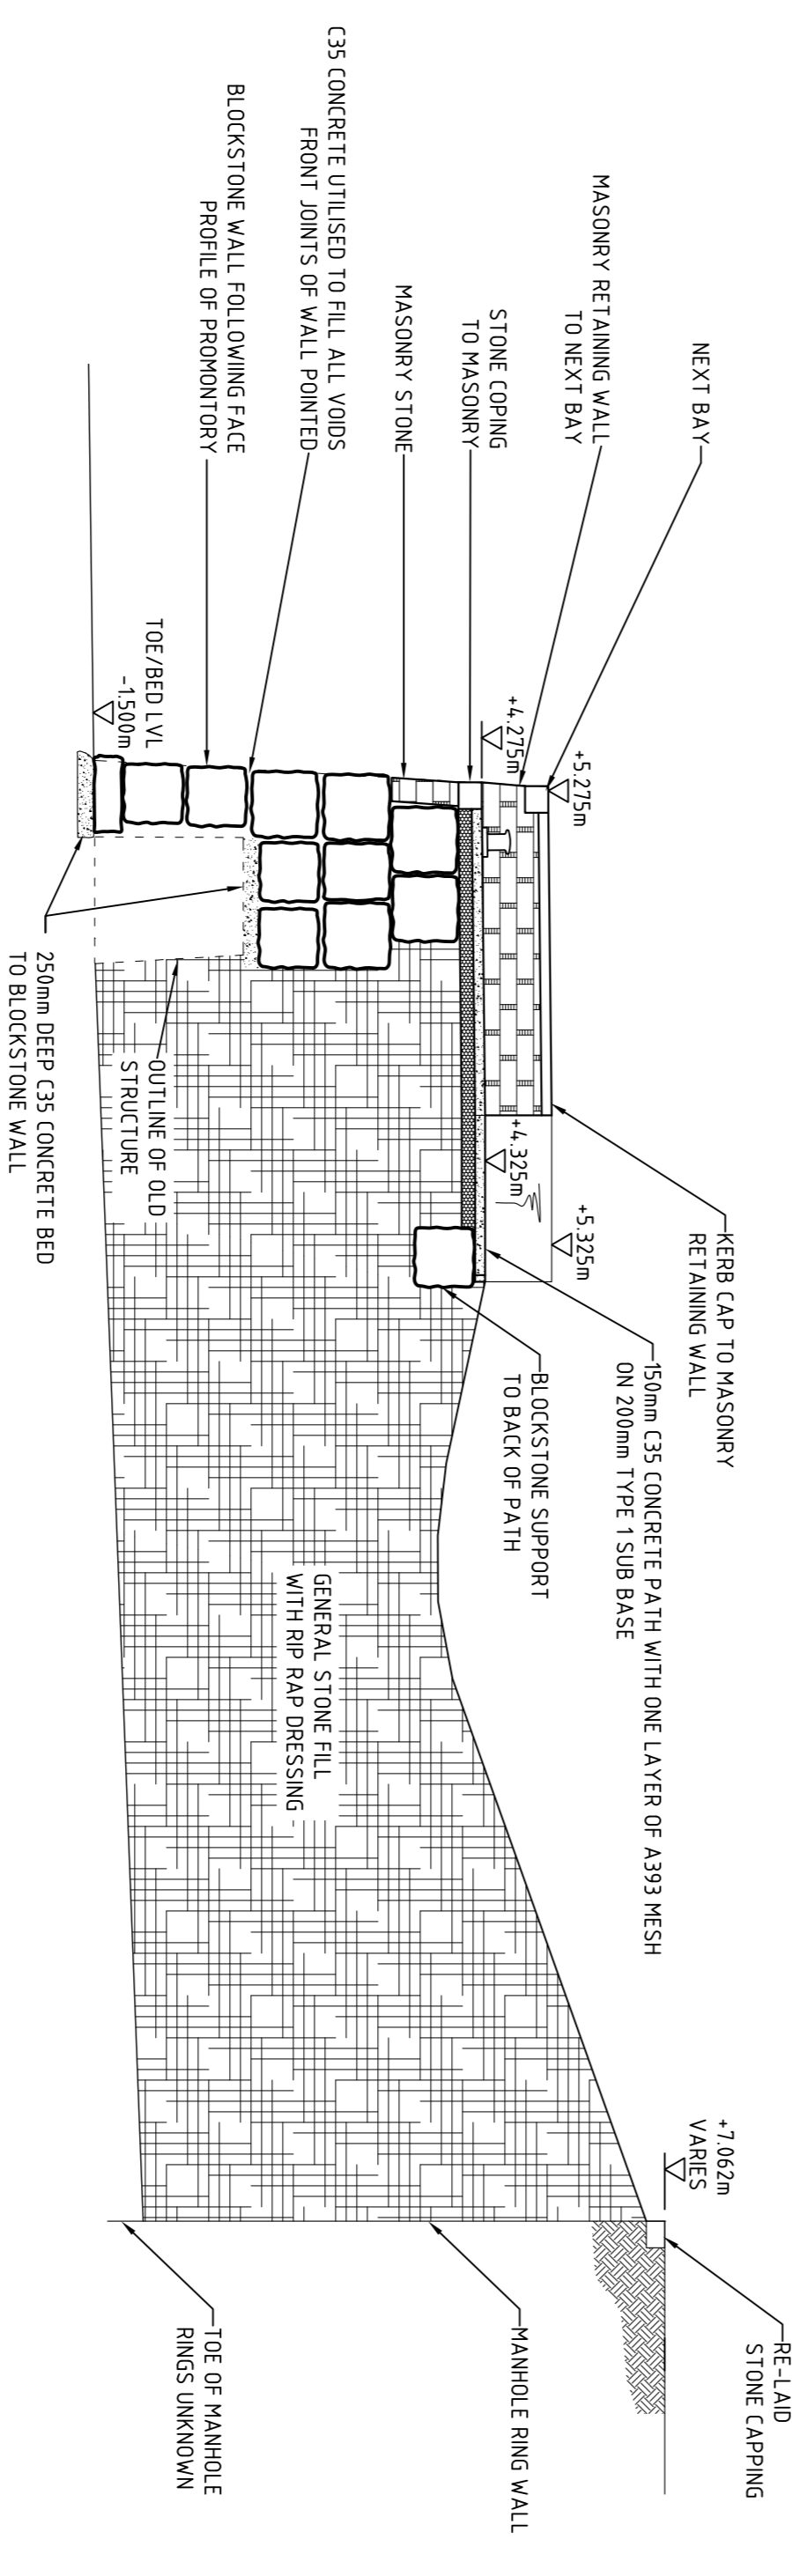

SECTION A-A  
SCALE 1:100

- NOTES
- DO NOT SCALE FROM THIS DRAWING USE FIGURED DIMENSIONS ONLY.
  - ALL DIMENSIONS ARE IN MILLIMETRES UNLESS OTHERWISE STATED.

ABBREVIATIONS

CJ = CONSTRUCTION JOINT  
LVL = LEVEL

ACT	AS CONSTRUCTED	DRN	DM	JM	JULY 10
Issue	Description	Drn	Chd	Appd	Date

Status	AS CONSTRUCTED	Catchment	SA1
Scale	See Dwg	Scheme Name	SA1 DEVELOPMENT
Original Size	A1	Date	JULY 10
Drawn by	M. Padich	Title	STEPPED KEY WALL FOR CATAMARAN DOCKING
Checked by	D. McCarthy	Approved by	J. McCarthy

**McCarthy Contractors (Bridgend) Ltd**

46A Village Farm Industrial Estate  
Pyle - CF33 6BP  
Tel: (01656) 74598 Fax: (01656) 74056

Catchment	SA1	File Name	MP/SA1/DWG/001	Status	AC	Series	1001	Revision	ACT
-----------	-----	-----------	----------------	--------	----	--------	------	----------	-----